

Replacement of Market Street Bridge at Santa Ana River

Between Hall Avenue and Rivera Street
In the Cities of Jurupa Valley and Riverside

Project No. C0-0528

Federal Aid No. BRLS-5956(200)

As-Built Bridge Plans

1953 Roadway Plans

Notice regarding these Plans:

These plans are provided for reference only.

Although this information represents the latest information available, the County of Riverside Transportation Department does not guarantee the accuracy of this data.

RIVERSIDE COUNTY

San Bernardino County

San Diego County

Corona

Lake Mathews

Perris

San Jacinto

Hemet

Banning

Beaumont

Indio

Coachella

Thermal



Melca

Banning

Scale 1" = 10 Miles

KEY MAP

INDEX	
Title Sheet	Sheet No 1
Typical Section	" " 2
Plan & Profile	" " 3-5
Intersection Details	" " 6-7
Curb Details	" " 8
Misc. Details	" " 8
Culvert Summary	" " 9
Standard Structures	" " 10-11
Cross Sections	" " 1-35
Mass Diagram	" " 1-1

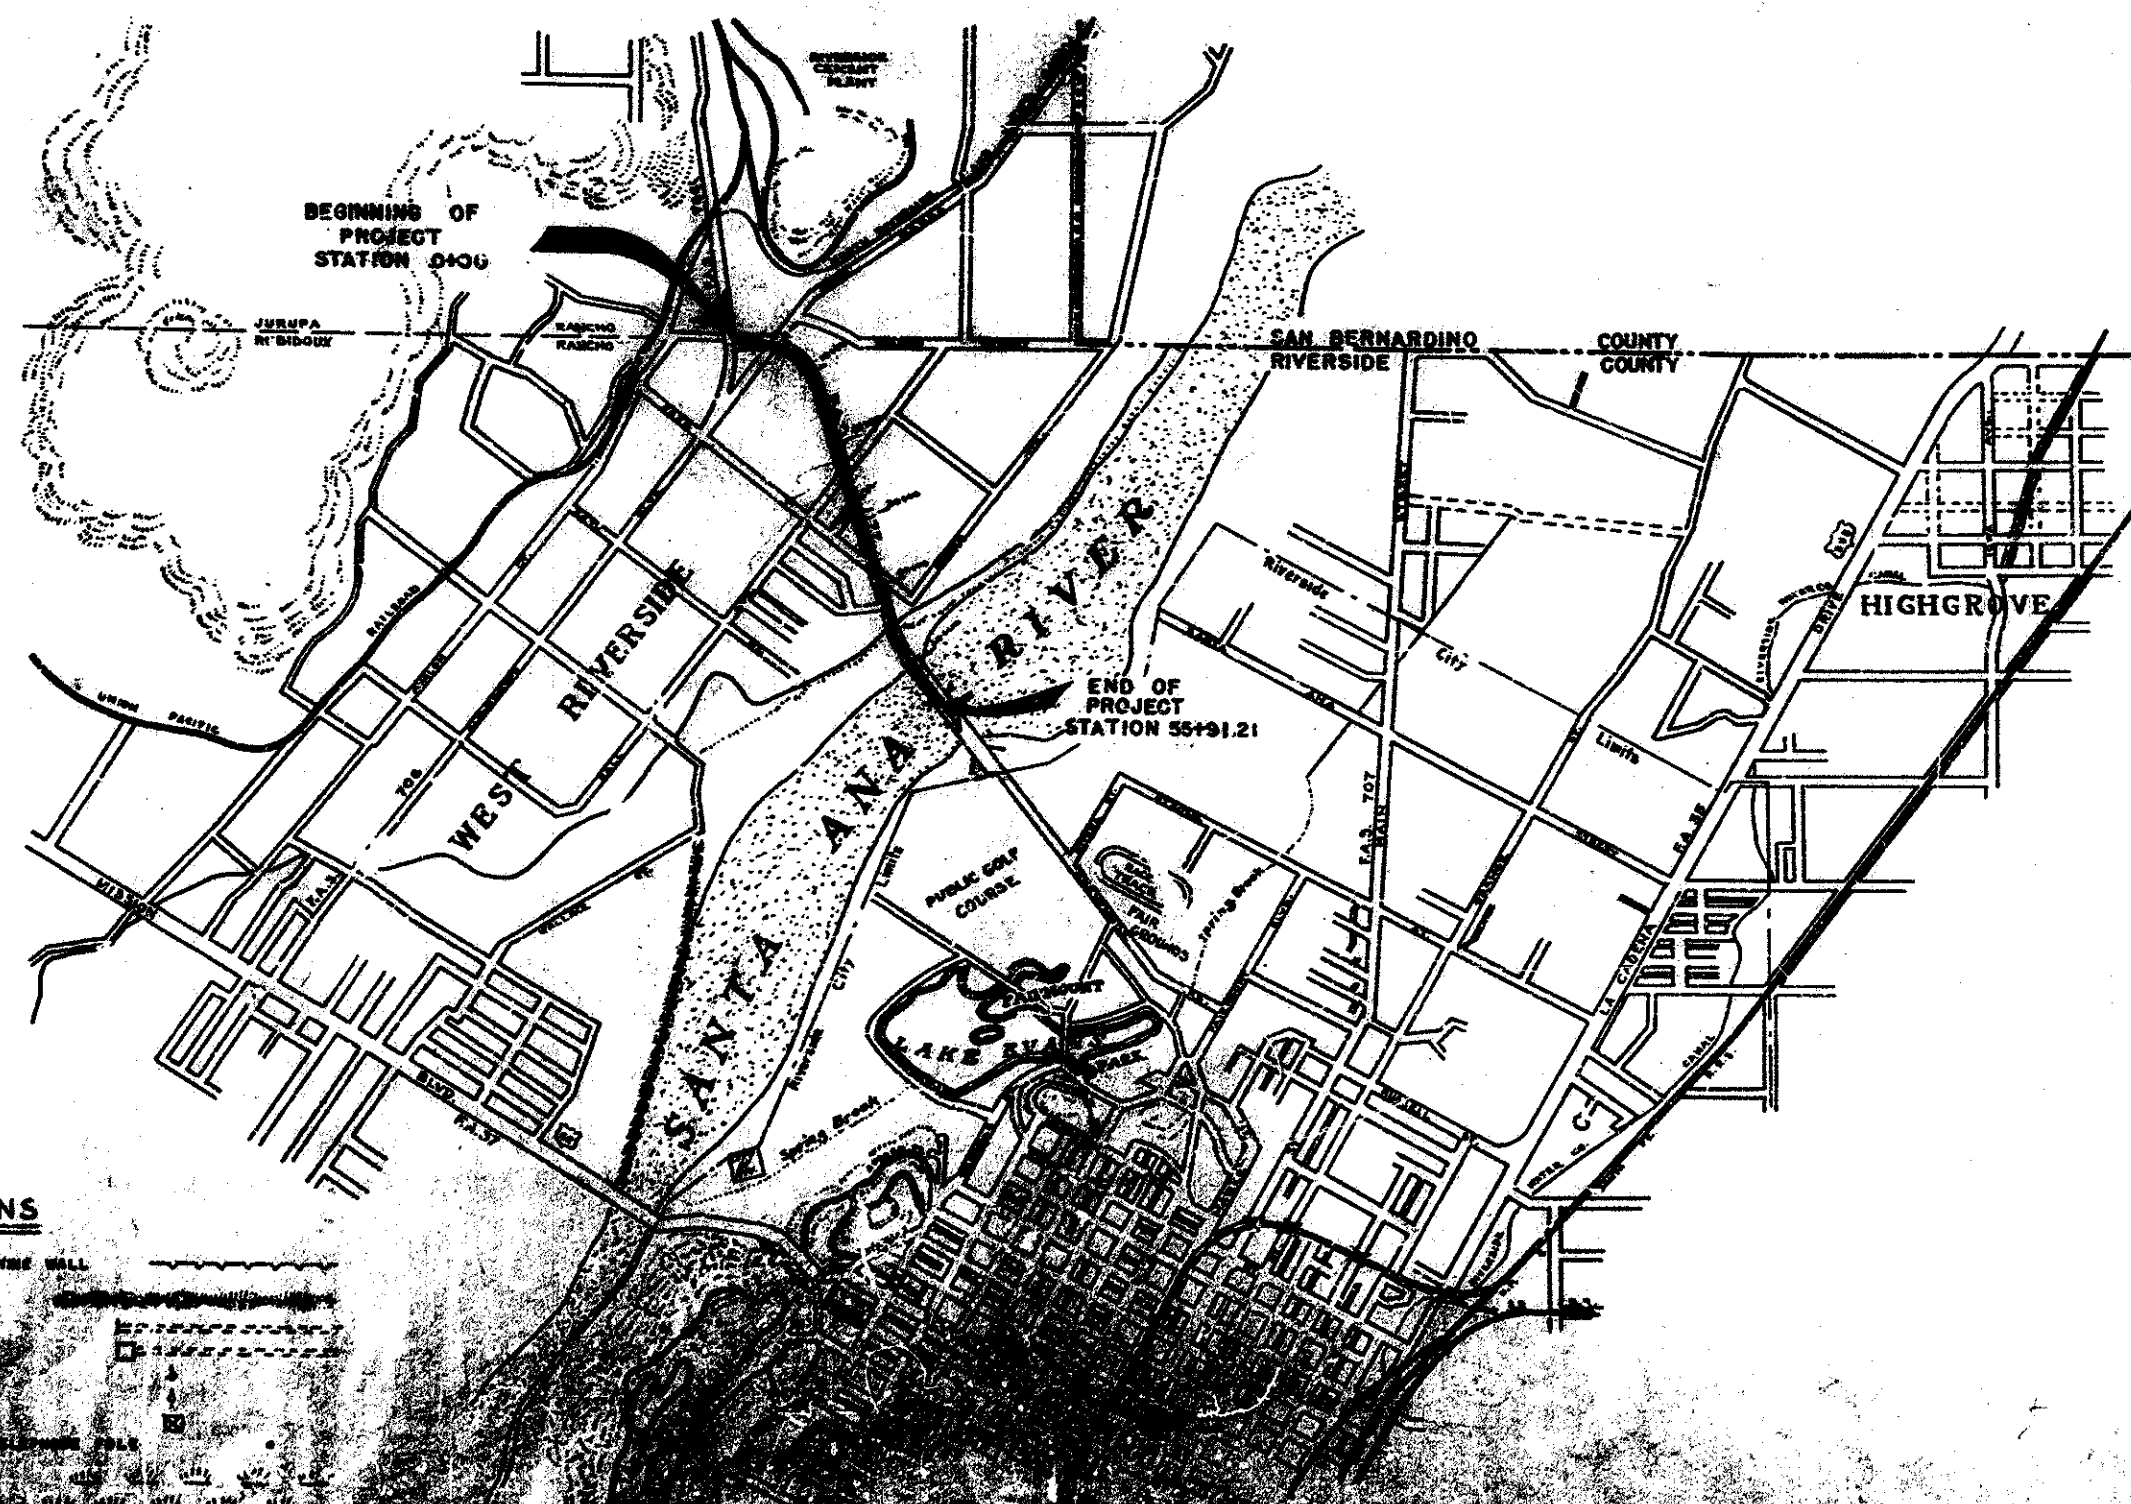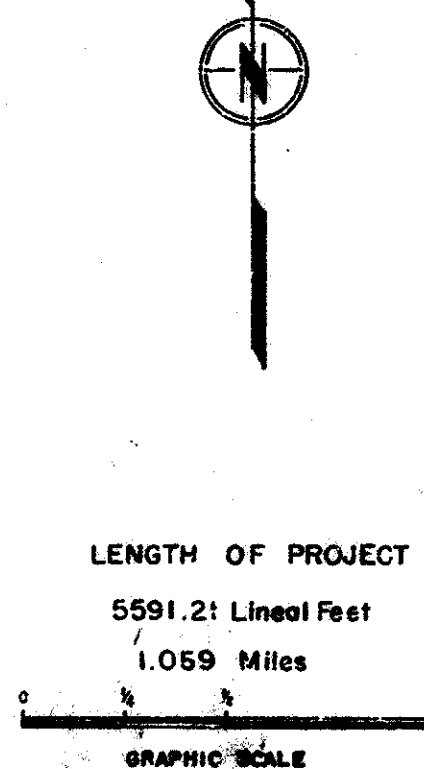[illegible]

COUNTY OF RIVERSIDE

----- A. C. Keith -----
COUNTY & SURVEYOR
ROAD COMMISSIONER
CIVIL ENGINEER LICENSE NUMBER 4388

APPROVED BY THE BOARD OF SUPERVISORS
DECEMBER 15, 1982

BY W. R. Jones
CHAIRMAN

STATE OF CALIFORNIA

ASSISTANT DISTRICT ENGINEER, DISTRICT VIII
APPROVED February 24, 1953

STATE HIGHWAY ENGINEER
CIVIL ENGINEER LICENSE NUMBER 2084

DEPT. OF COMMERCE
BUREAU OF PUBLIC ROADS


RECOMMENDED FOR APPROVAL

DISTRICT ENGINEER
DEPT. OF COMMERCE
BUREAU OF PUBLIC ROADS

APPROVED

DIVISION ENGINEER
DEPT. OF COMMERCE
BUREAU OF PUBLIC ROADS

53-8DC5 846 AA


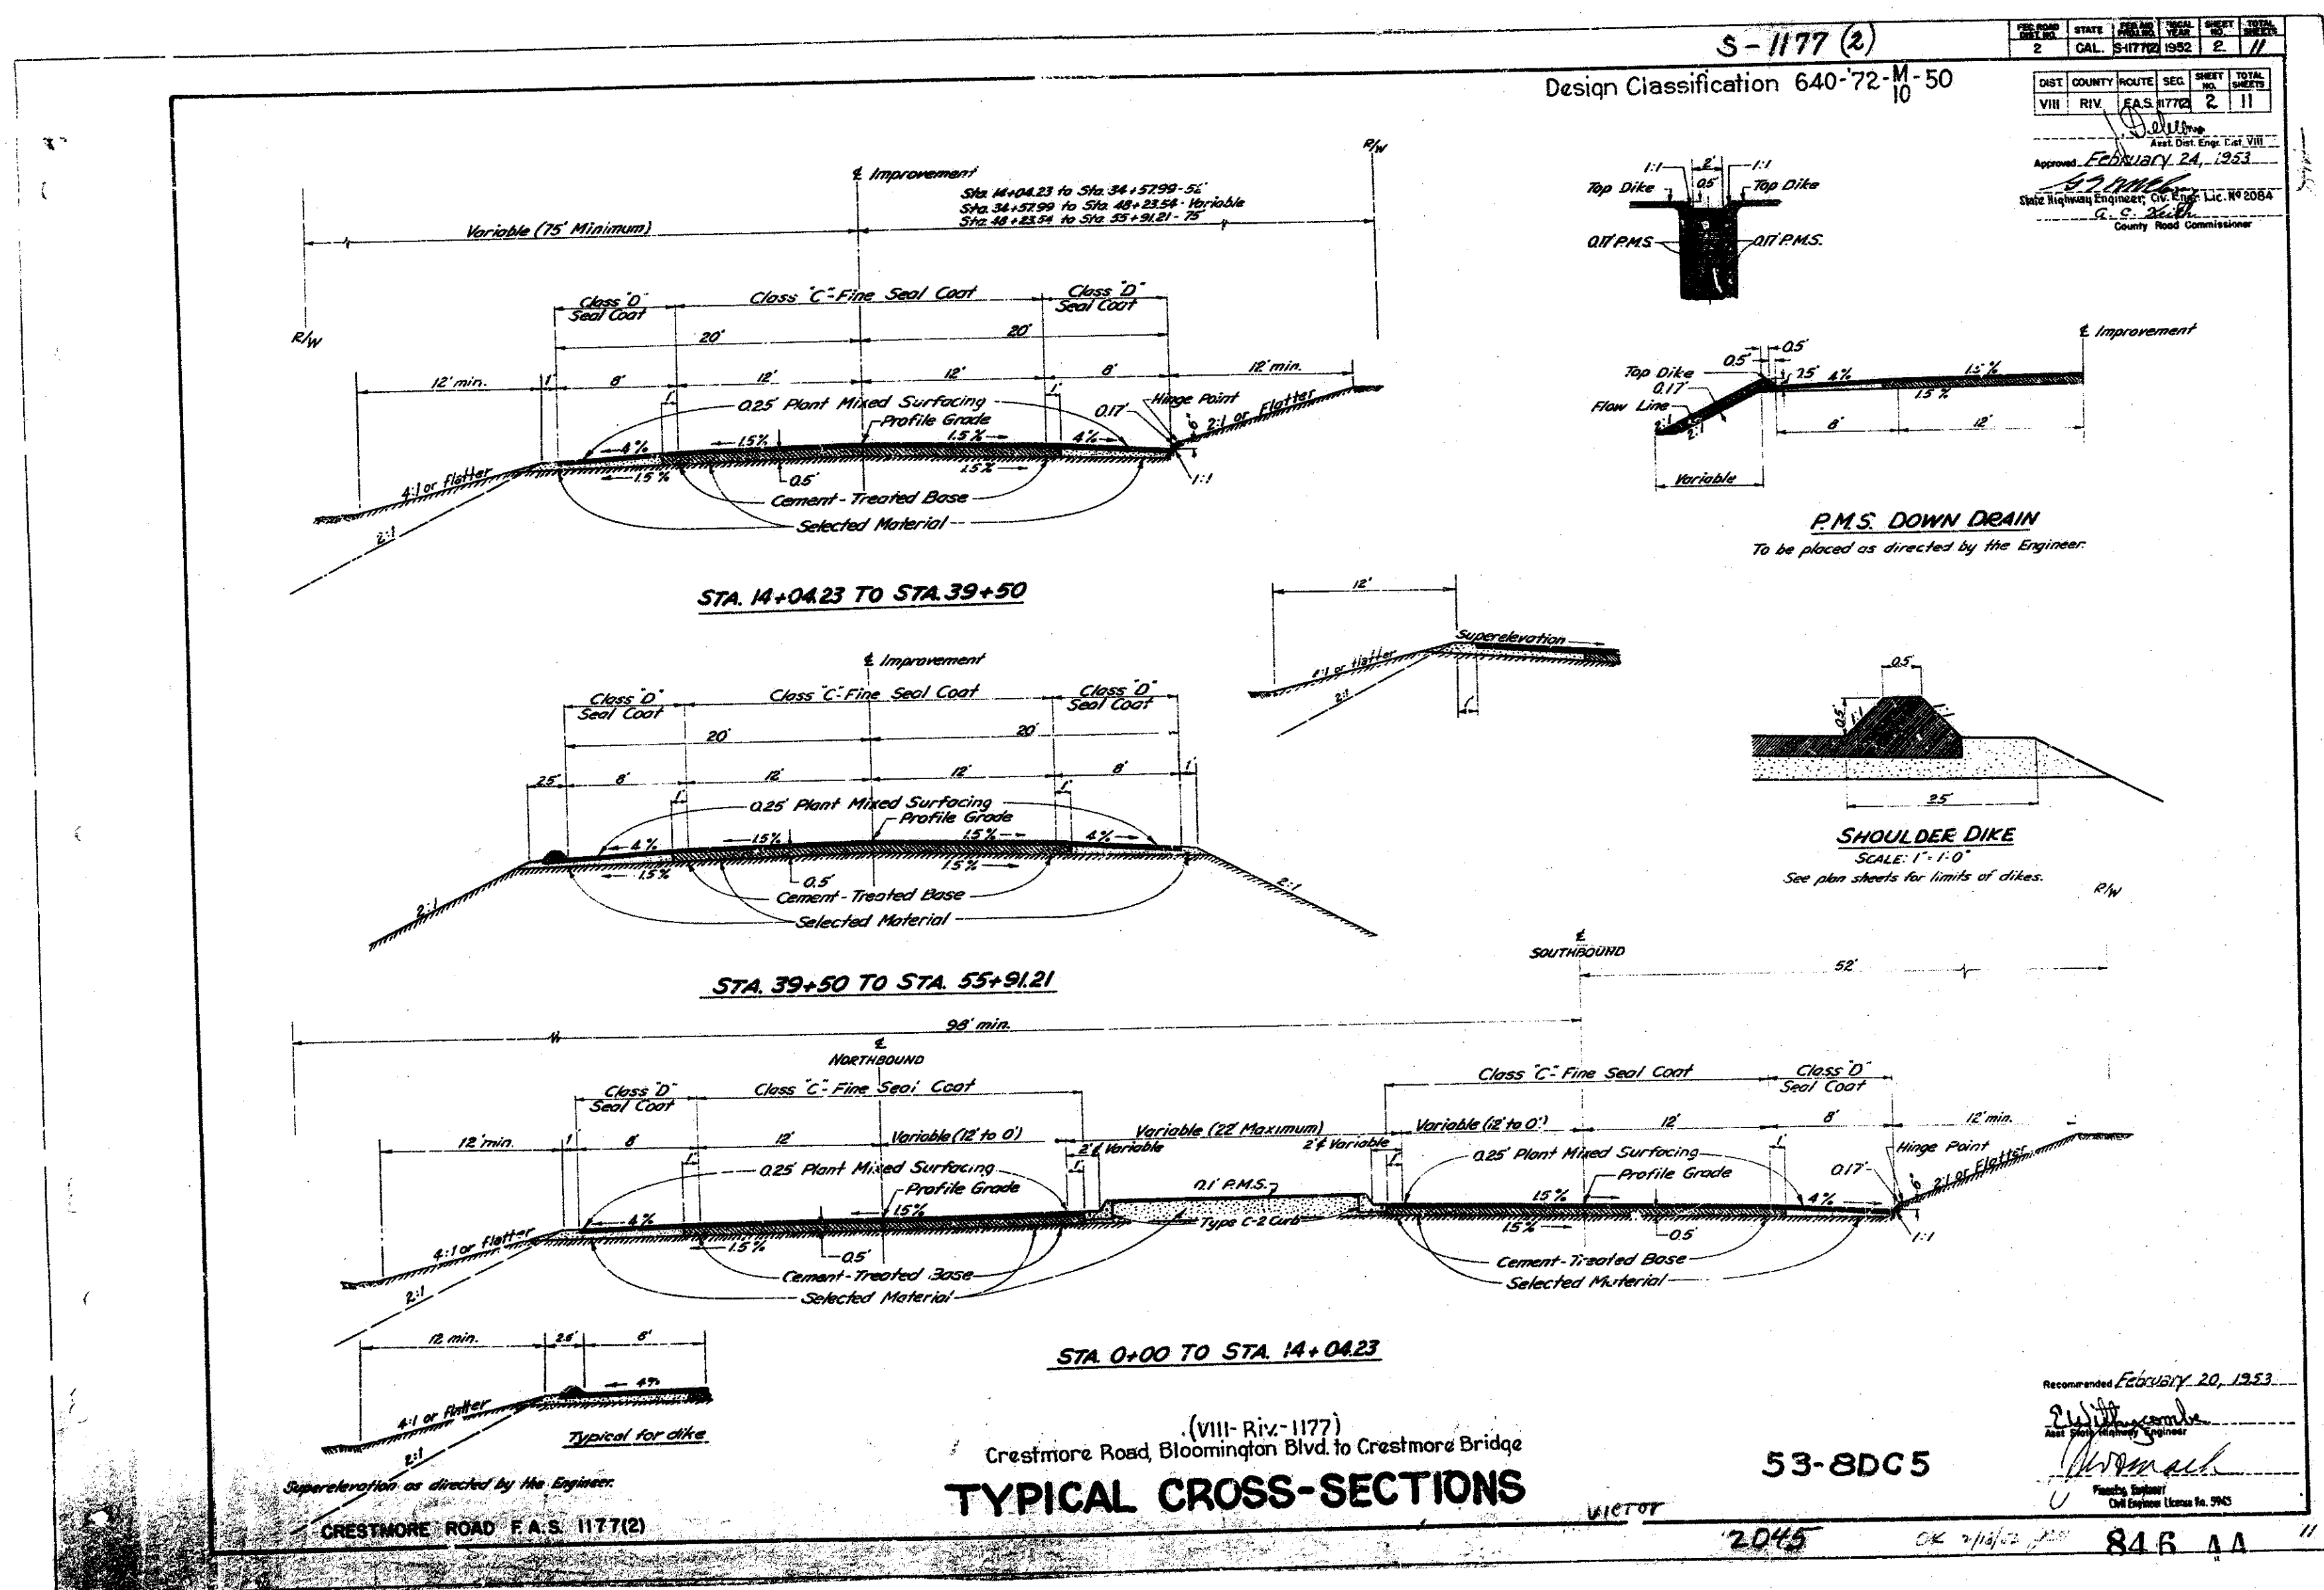


5-1177 (2)

5-1177 1952 3 11

DIST	COUNTY	ROUTE	SEC	SHEET NO.	TOTAL SHEETS
VIII	RIV.	FAS 1177	3	11	

Approved: February 24, 1953
G. A. [Signature]
County Road Commissioner

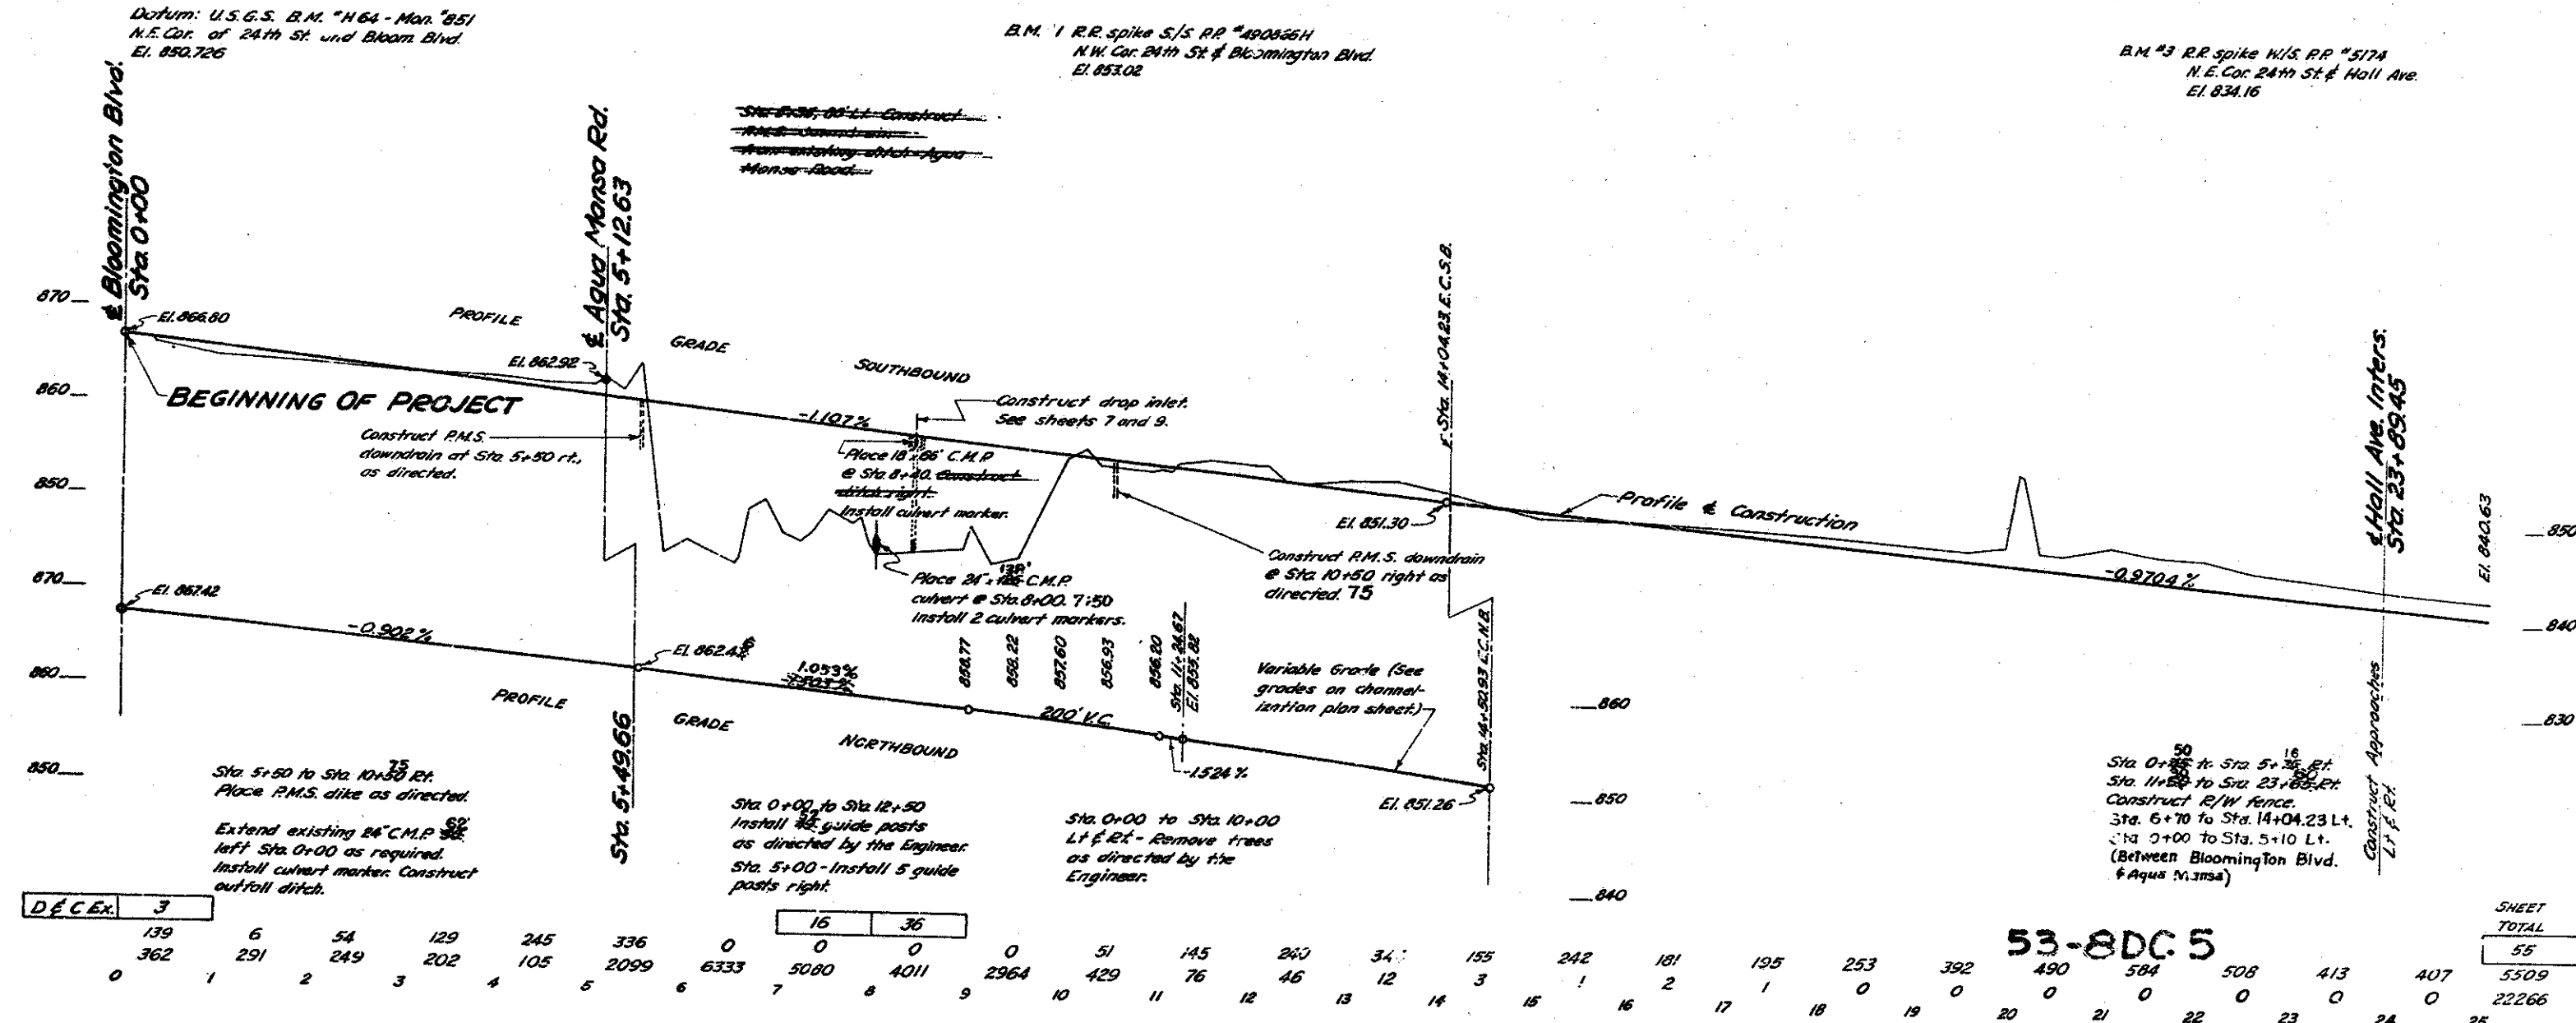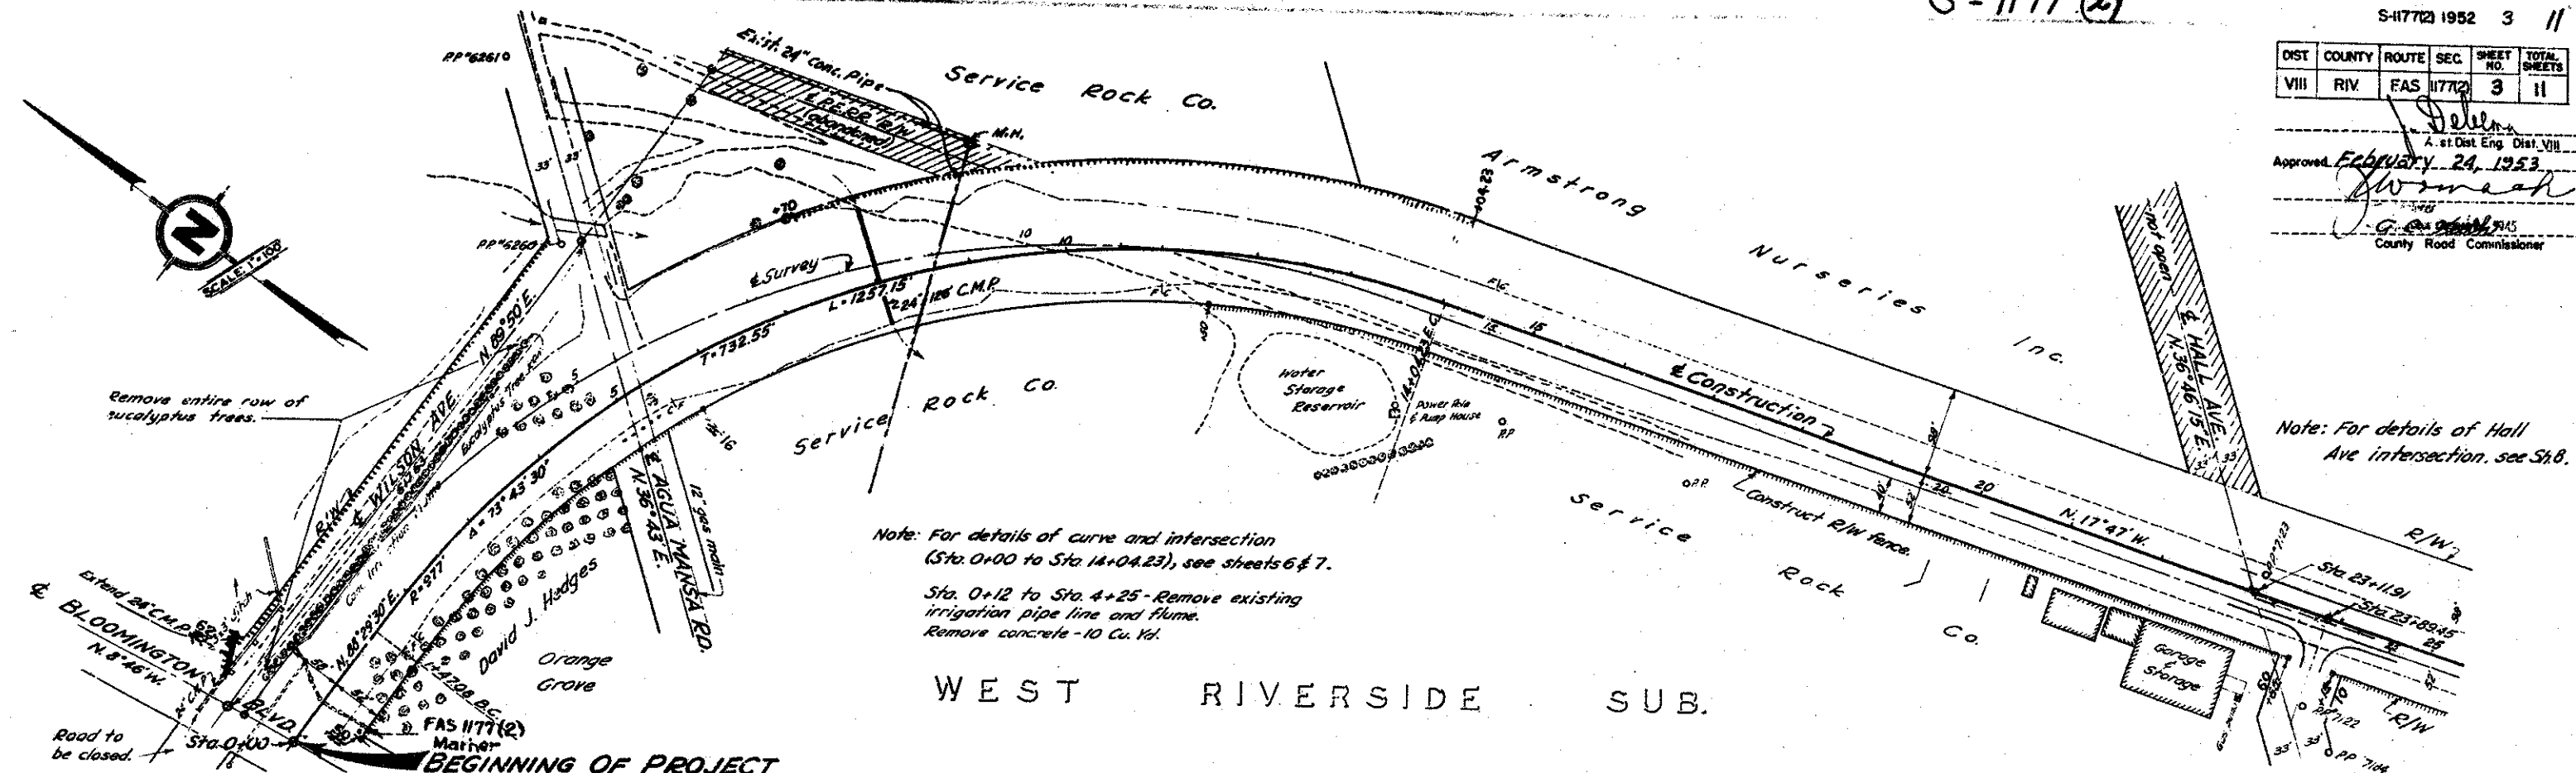


S-1177 (2)

S-11772 1952 4 //

DIST	COUNTY	ROUTE	SEC.	SHEET NO.	TOTAL SHEETS
VIII	RIV	EAS #772	4	11	11


Approved February 24, 1953
 G.C. [Signature]
 County Road Commissioner

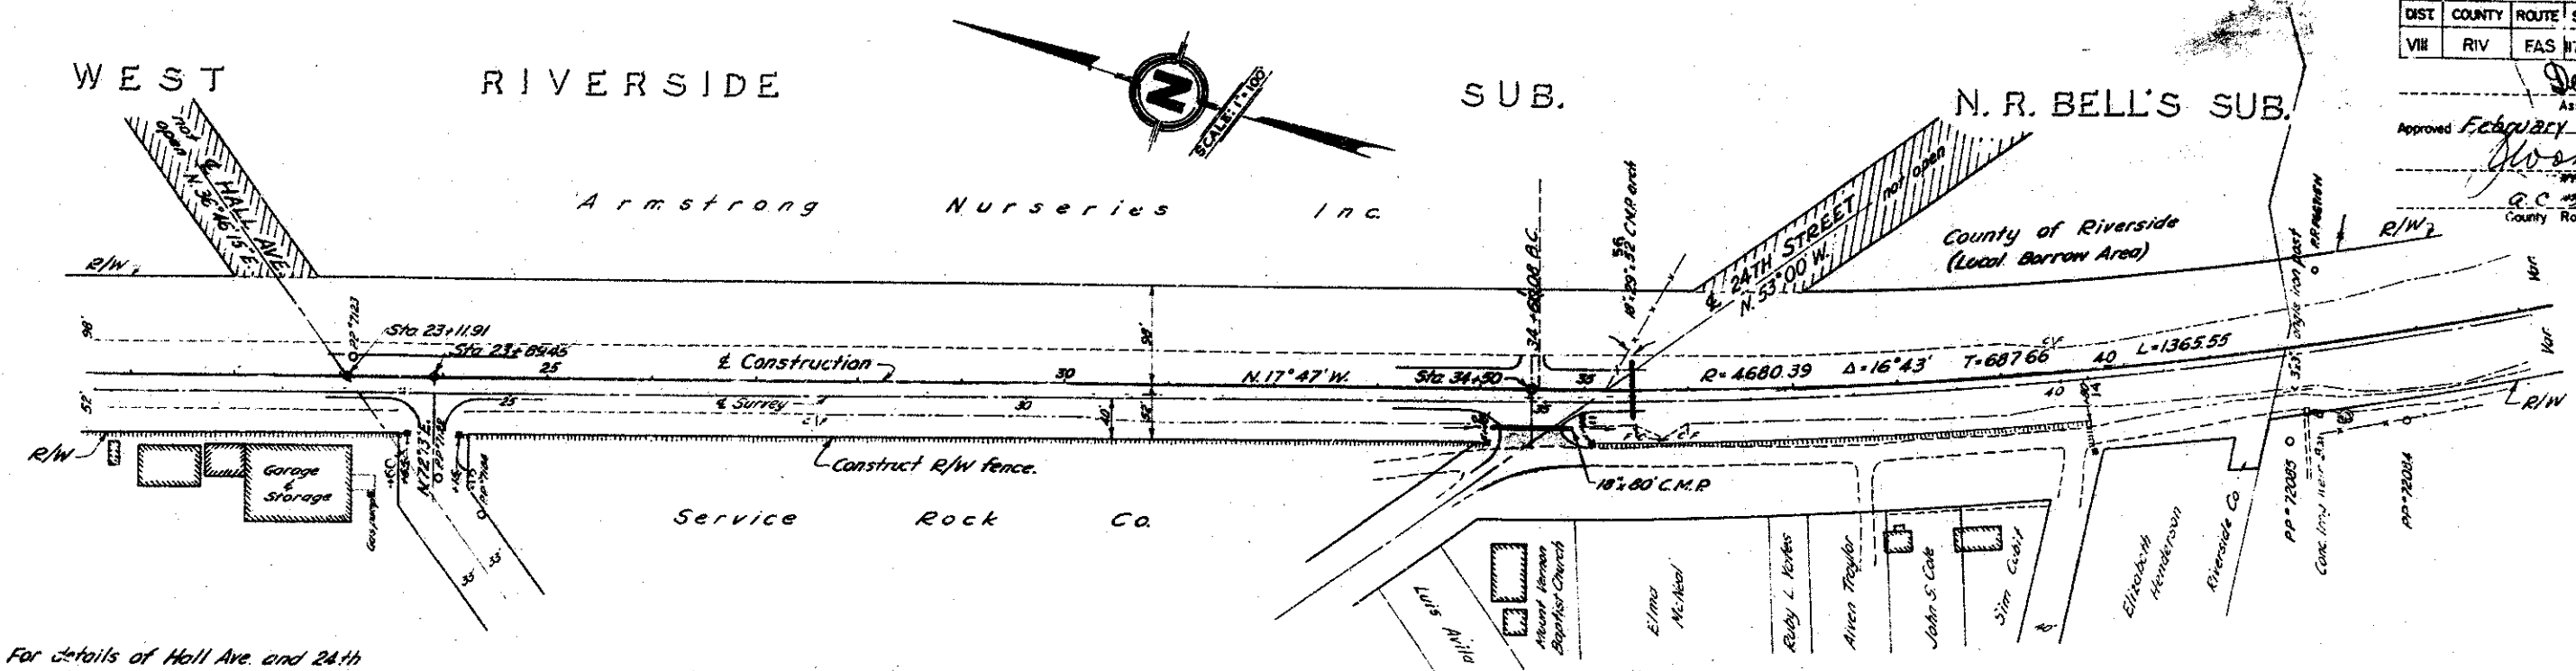

Note: For details of Hall Ave. and 24th Street intersections, see Sheet 6.

PHISTER'S SUB.
 M.B. 9-78

CIUDAD MEXICANA DE ALVARADO
 M.B. 11-70

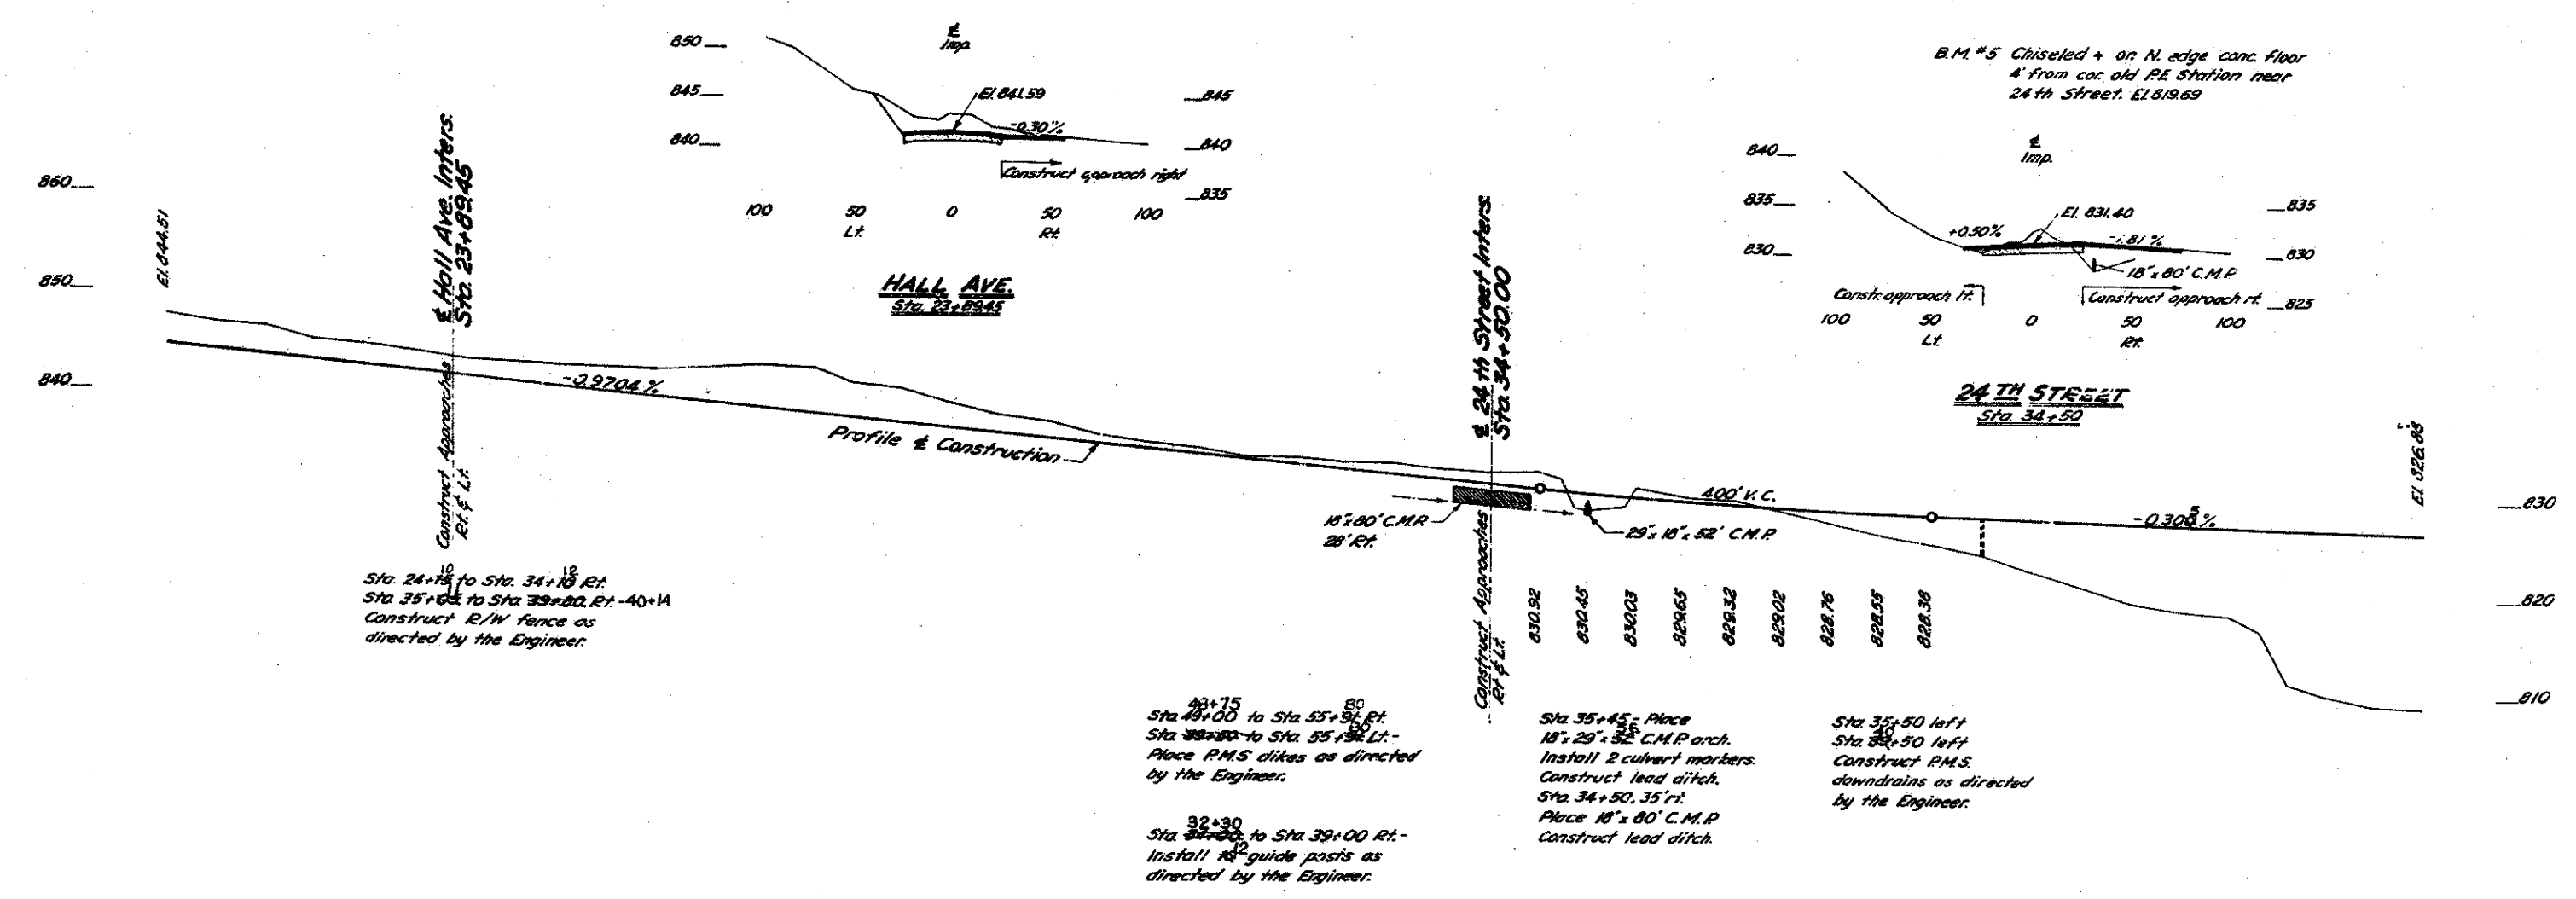

Sta 24+18 to Sta 34+18 Rt.
 Sta 35+04 to Sta 39+02 Rt. 40+14
 Construct R/W fence as directed by the Engineer.

Sta 32+15 to Sta 33+50 Rt.
 Sta 33+50 to Sta 35+14 Lt.
 Place P.M.S. dikes as directed by the Engineer.

Sta 32+30 to Sta 33+00 Rt.
 Install 18" guide posts as directed by the Engineer.

Sta 35+45 Place 18" 25' 82" C.M.P. arch.
 Install 2 culvert markers.
 Construct lead ditch.
 Sta 34+50, 35+14 Place 18" 80' C.M.P.
 Construct lead ditch.

Sta 35+50 left
 Sta 36+50 left
 Construct P.M.S. downdrains as directed by the Engineer.

D.C. Eng.

																								← LOCAL BORROW - 114,533 C.Y. →													
																								4 18													
																								84	175												
																								121	186	108	201	140	19	0	0	53-800.5		0	0	SHEET TOTAL	
21	22	23	24	25	26	27	28	29	30	31	32	33	34	35	36	37	38	39	40	41	42	43	44	45													
				465	530	592	377	233	159	105	106	93																									
				0	0	2	6	6	13	22	48	93																									

